



NOTE: HALFWAY BLVD. IS ASSUMED TO RUN IN AN EAST-WEST DIRECTION.

THERE ARE TWO(2) HANDHOLES WITHIN THE BREAK


PROPOSED SIGNALS

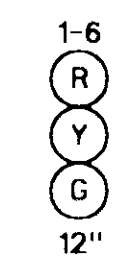

NEMA PHASING

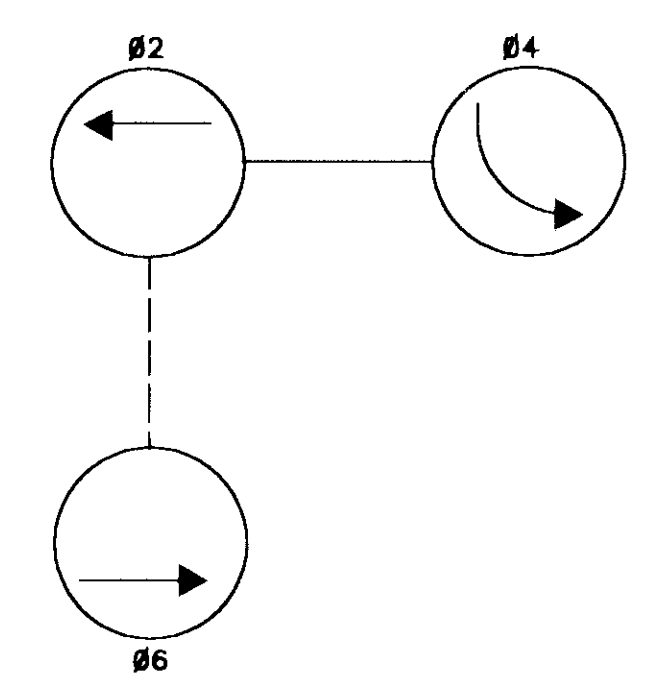

PHASING NOTES:  
1. PHASES ASSOCIATED BY A SOLID LINE WILL NOT OPERATE CONCURRENTLY.  
2. PHASES ASSOCIATED BY A DASHED LINE WILL OPERATE CONCURRENTLY.

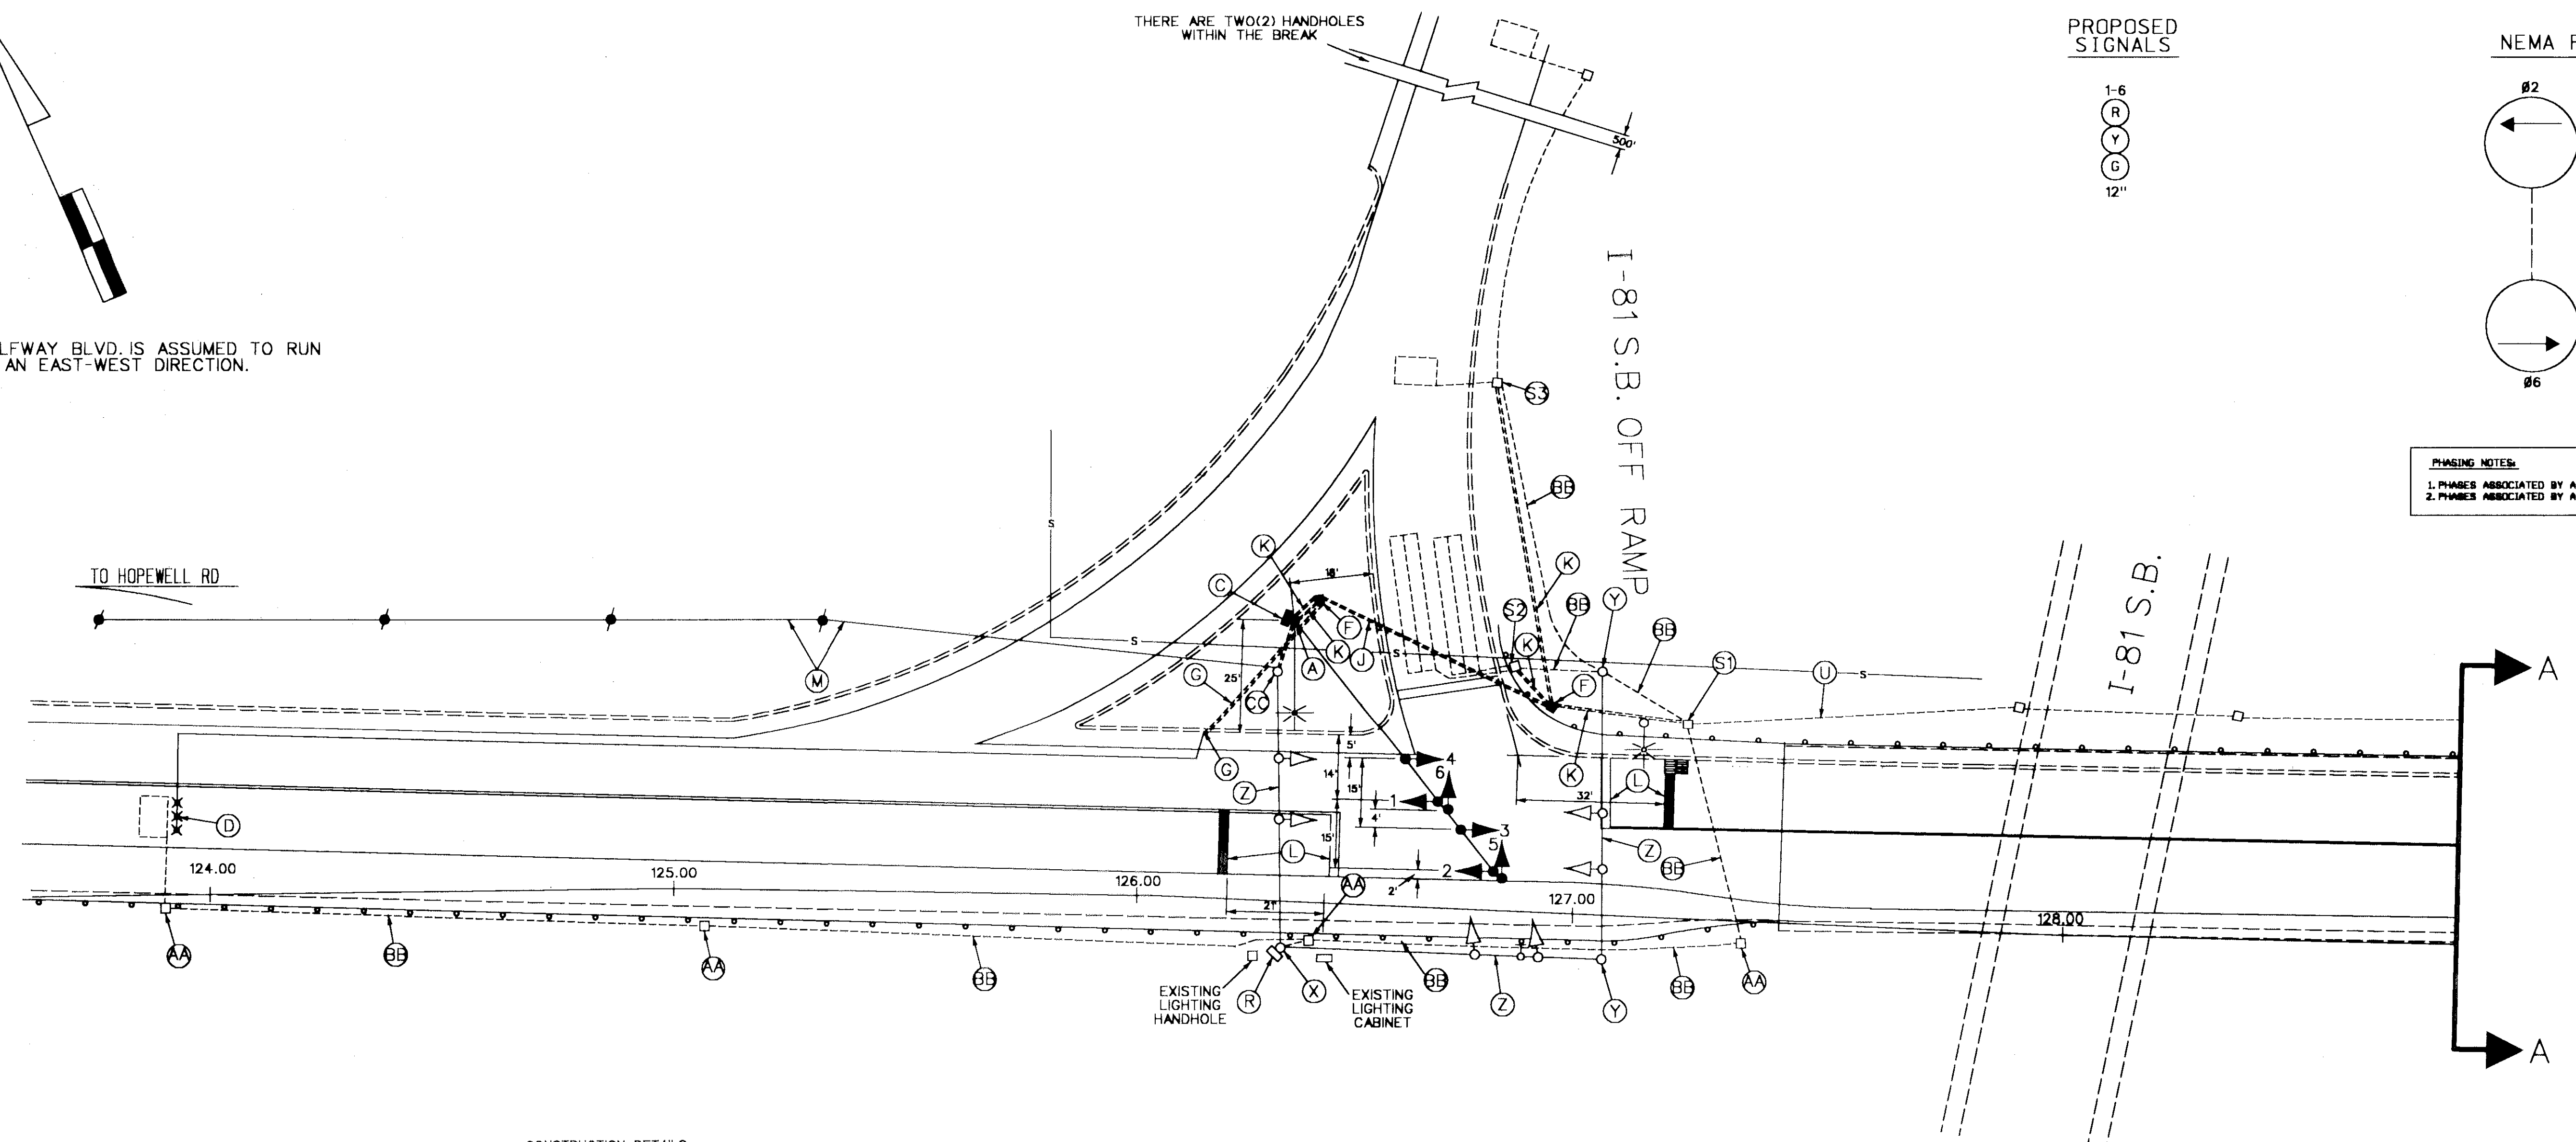

CONSTRUCTION DETAILS



- A. Install 27' steel pole with a 70' mast arm, traffic signal heads, 20' lighting arm with a 250W-HPS luminaire as shown. (Note: 1-2", 90° polyvinyl chloride (Schedule 80) bend and 2-3", 90° polyvinyl chloride (Schedule 40) bends.)
- C. Install NEMA size "5" pole-mounted cabinet and controller with all necessary equipment as shown. (Note: 1-3" LB)
- D. Install micro-loop probe as shown.
- F. Install handhole.
- G. Install 1" galvanized steel electrical conduit (detector wire sleeve).
- J. Install 3" polyvinyl chloride electrical conduit (Schedule 80) (pushed).
- K. Install 3" polyvinyl chloride electrical conduit (Schedule 40) (trenched).
- L. Remove existing stopline and install new stopline as shown.
- M. Proposed overhead electrical service by Allegheny Power Company to existing strain pole.
- R. Pull back existing 20-conductor cable, 12-pair interconnect cable and mainline detector cable from the existing pole-mounted cabinet to handhole noted as Construction Detail "S1". Reroute cable to proposed pole-mounted cabinet as shown in the Wiring Diagram. Pull back existing I-81 detector cable (presense loops and queue) from cabinet across span to the existing pole on the northeast quadrant and to the existing handhole. (The Queue loop will be pulled to handhole detail "S2" and the Presense loops to detail "S3") and reroute to the proposed cabinet.
- S1-3. Use existing handhole. See Construction Detail "R" and Wiring Diagram.
- U. Use existing conduit.
- V. Use existing pole.
- W. Use existing span.
- X. Remove existing pole, equipment and cabinet - foundation shall be chipped 12" below grade.
- Y. Remove existing pole and foundation 12" below grade.
- Z. Remove existing span, signal heads and sign.
- AA. Remove existing handhole.
- BB. Cap and abandon existing conduit.
- CC. Use existing pole, install 2" pvc conduit to existing 2" bend in the pole base for the service of the mast arm structure. The meter socket and disconnect switch shall be located on the existing pole.

GENERAL NOTES

- 1. Electrical service shall be provided by Allegheny Power Co. to the North Side of Halfway Blvd.
- 2. Interconnection and Detection shall be maintained and the rewiring will be performed during off-peak hours.
- 3. Signal Reconstruction shall be completed prior to M.O.T. Phase I.
- 4. The Ultimate Signal Design shall be completed prior to M.O.T. Phase III.
- 5. When the ultimate signal is turned on, the contractor shall remove the temporary signal. The mast arm, pole and cabinet/controller shall be returned to the MSHA signal shop.

TEMPORARY SIGNAL M.O.T. PHASE I

UTILITY LEGEND

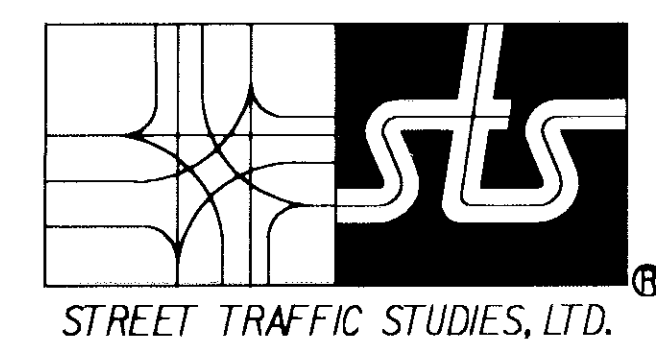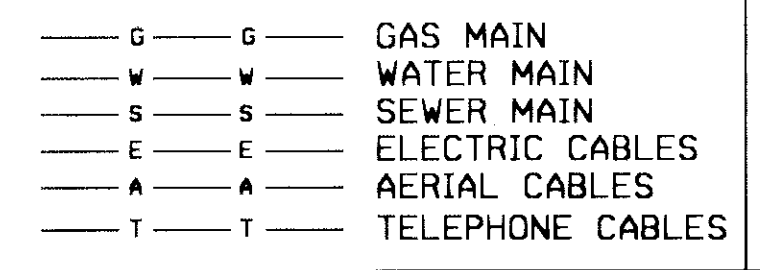

Gateway International  
1302 Concourse Drive, Suite 104  
Linthicum, Maryland 21090  
Ph (410) 859-3553  
Fax (410) 859-3579

TASK 111 T.DGN

REVISIONS

1	9/2/88	MODIFIED FOR HWY. PROJECT M.O.T.
2	10/2/88	SHA NO. WA923821
3	11/88	INSTALL QUEUE DET. ON S/R I-81 OFF RAMP
4	8/24/79	ASBUILT
5		SHA NO. 1

APPROVALS

ASST. CHIEF TRAFFIC SECTION
ASST. DISTRICT ENGINEER, TRAFFIC
CHIEF, TRAFFIC ENGINEERING DESIGN DIVISION
DIRECTOR, TRAFFIC & SAFETY

MARYLAND DOT - STATE HIGHWAY ADMINISTRATION  
Office of Traffic & Safety  
TRAFFIC ENGINEERING DESIGN DIVISION  
I-81 SOUTHBOUND AND HALFWAY BOULEVARD

DRAWN BY: J. GORDON	COUNTY: WASHINGTON	TS NO. 1582D	SHEET NO. 1 OF 7
CHECK BY: 5/78	LOG MILE:	F.A.P. NO.	
SCALE: 1" = 20'	S.H.A. NO. W-704-501-685	T.J.M.S. NO.	

FA 596